
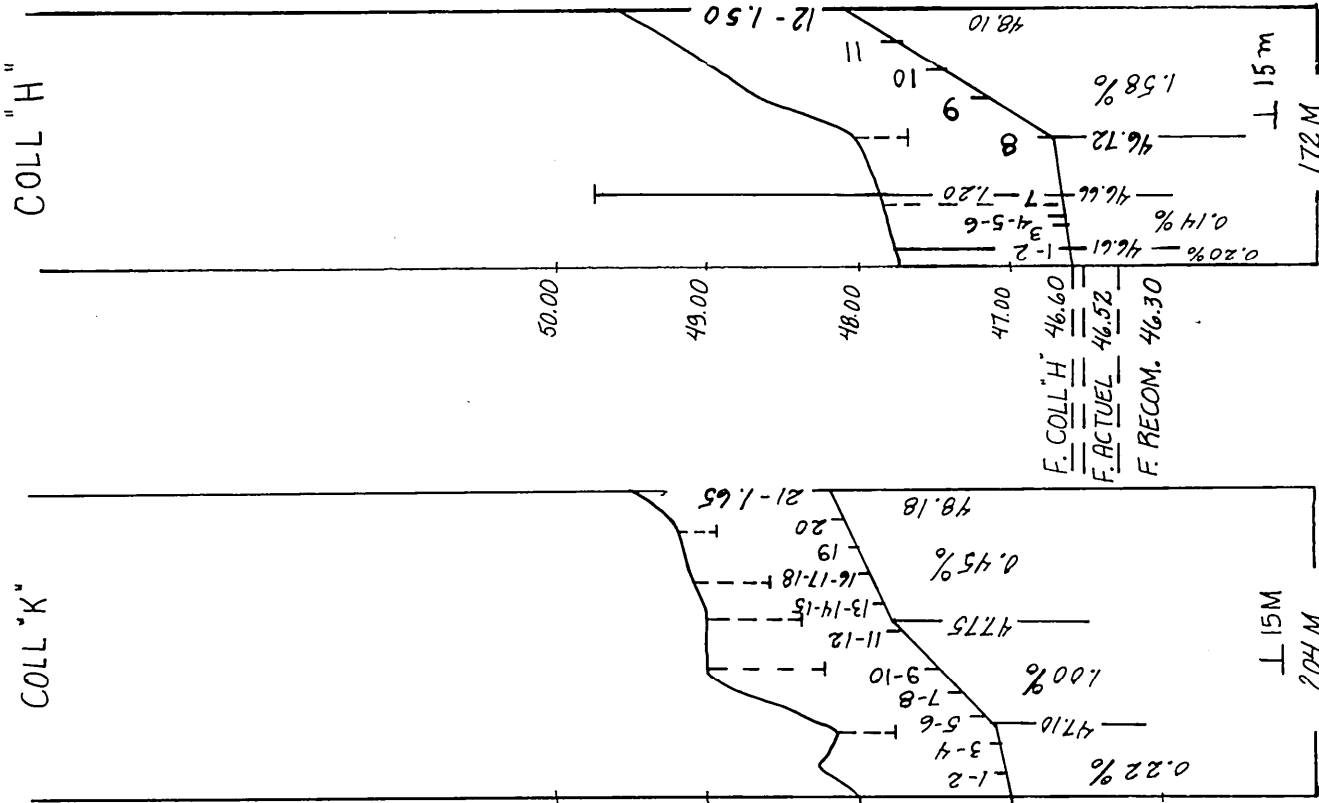
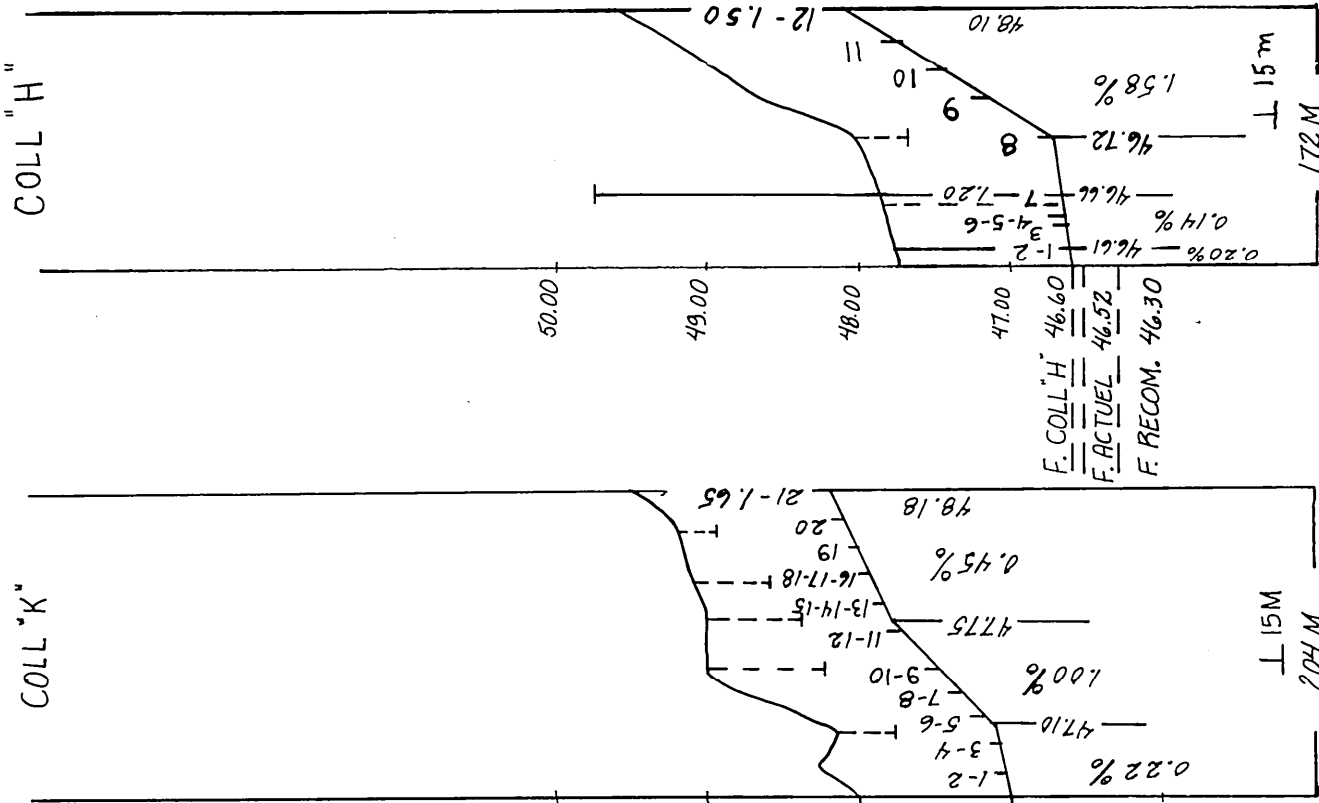
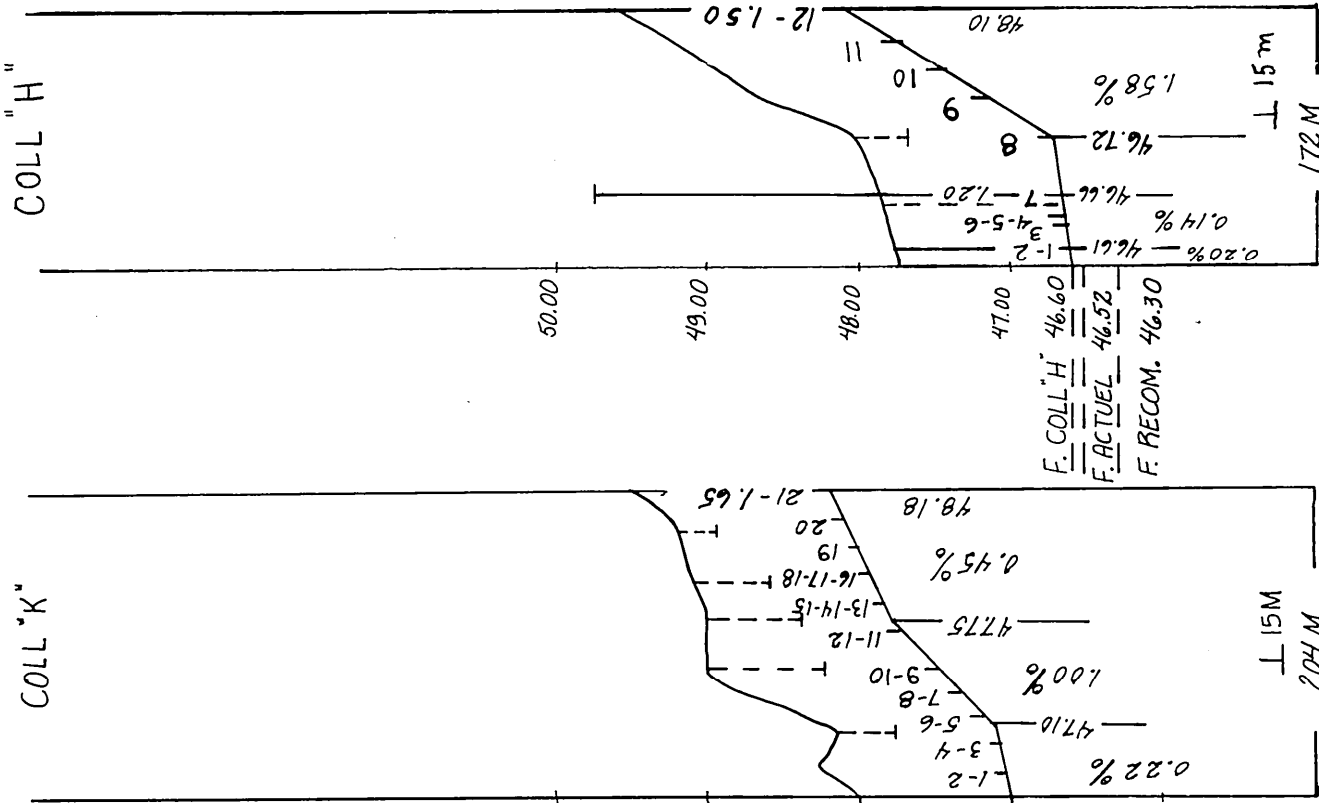


~~drainages~~ en 1982

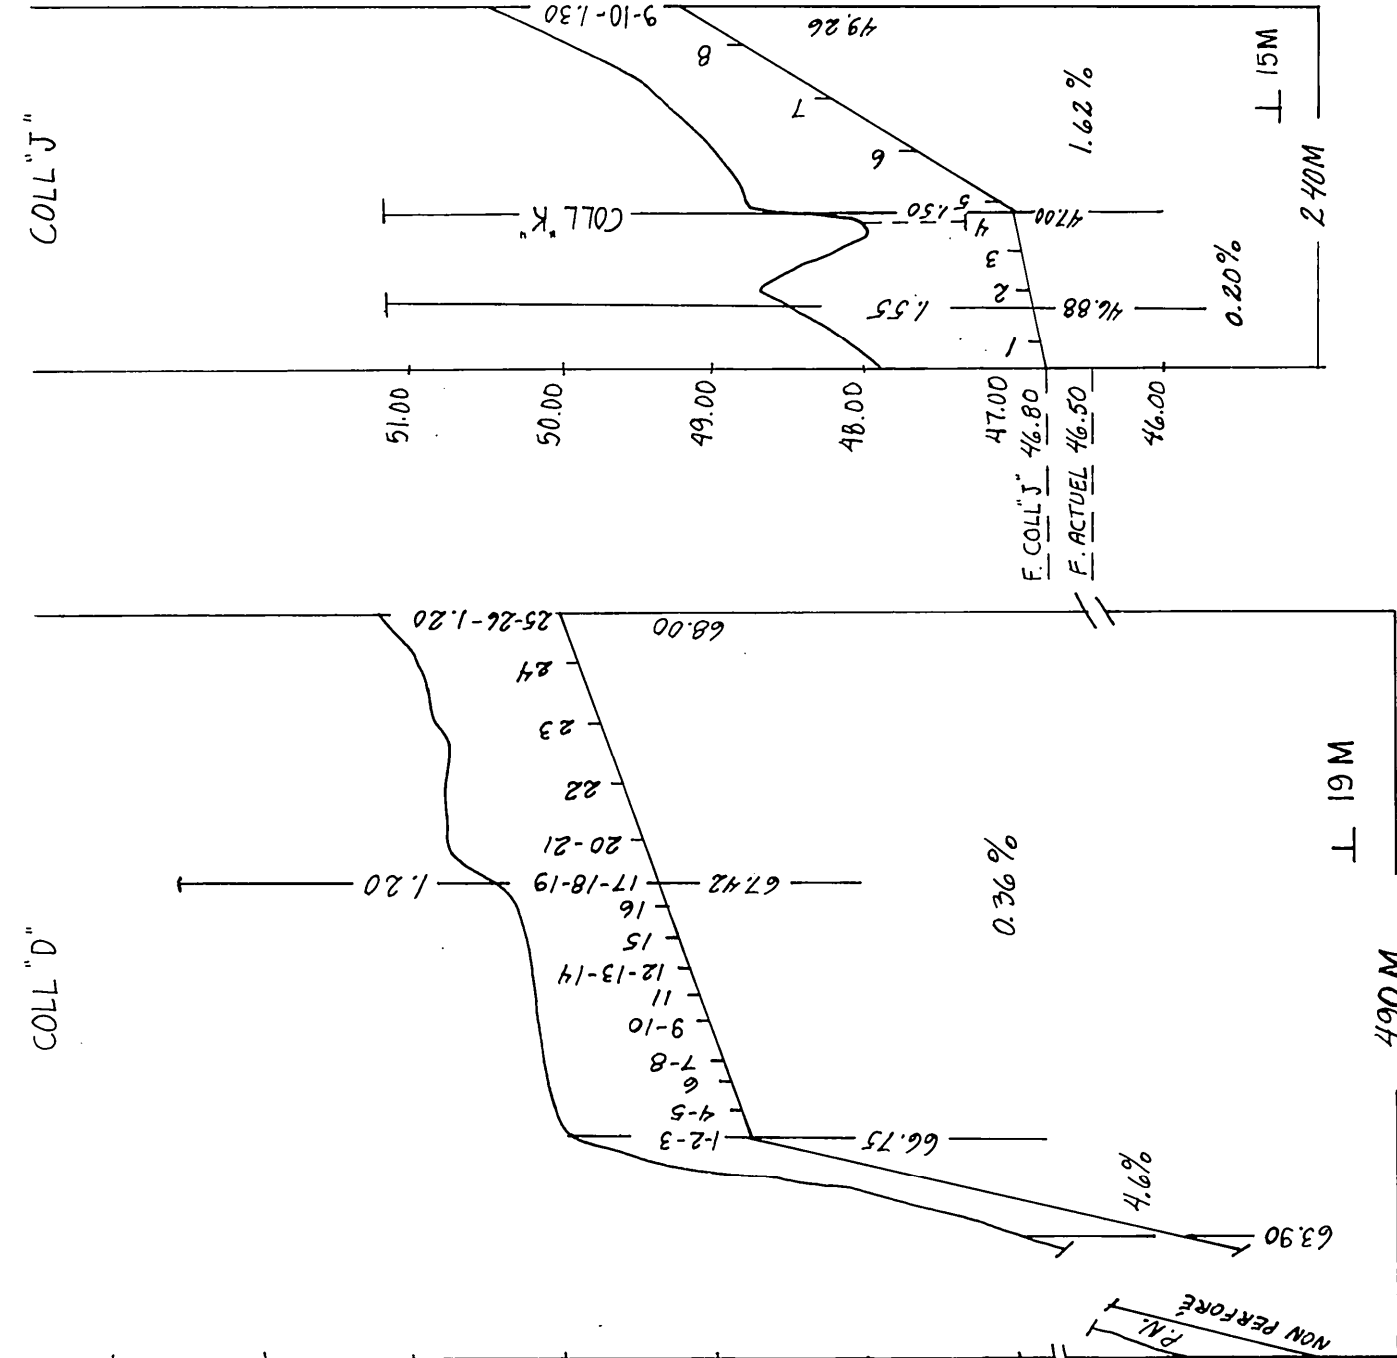

4876

$$B25 = 100$$

397 93

DESIGNATION	DRAINS REQUIS					
	COLLECTEUR TERRE CUITE		L'ATELIER DE LA FEMME		COLLECTEUR POLYÉTHYLÈNE	
	200mm	150 mm	100mm	100 mm	250 mm	200 mm
A			126	982		
B		35	225	4194		
C			12	366		
D		200	292	2637		
E			6	244		
F			10	228		
G			5	185		
H			240	1039		
J		96	144	804		
K			204	1614		
M						
N						
TOTAL		331	1264	12 4133		
GRAND TOTAL				140208 mètres		

PLAN DE LOCALISATION

échelle: 1 : 20.000 référence: 21 L-06

SUPERFICIE ÉTUDIÉE: 240 HA 18.7 ACRES 913 ARP.

SUPERFICIE DRAINÉE: 240 HA 18.7 ACRES 913 ARP.

(a)
 (b)
 (c)
 (d)
 (e)
 (f)
 (g)
 (h)
 (i)
 (j)
 (k)
 (l)
 (m)
 (n)
 (o)
 (p)
 (q)
 (r)
 (s)
 (t)
 (u)
 (v)
 (w)
 (x)
 (y)
 (z)
 (aa)
 (ab)
 (ac)
 (ad)
 (ae)
 (af)
 (ag)
 (ah)
 (ai)
 (aj)
 (ak)
 (al)
 (am)
 (an)
 (ao)
 (ap)
 (aq)
 (ar)
 (as)
 (at)
 (au)
 (av)
 (aw)
 (ax)
 (ay)
 (az)
 (ba)
 (bb)
 (bc)
 (bd)
 (be)
 (bf)
 (bg)
 (bh)
 (bi)
 (bj)
 (bk)
 (bl)
 (bm)
 (bn)
 (bo)
 (bp)
 (bq)
 (br)
 (bs)
 (bt)
 (bu)

Échelle duplan

Echelle des profils

1 : 2000

Vert. 1:50
Horiz. 1:5000

MARIO COSSETTE, INC.
525, RUE BARKOFF
CAP-DE-LA-MADELEINE

PROJET PRÉPARE POUR:

AM JAINÂTBE

LOAM ORGANIQUE

AIM CHAINMAIL

LOAM SABLEUX JAUNÂTRE

BLE GRIS ASSEZ FIN

SABLE BRUN GROSSIER

BLE ARGILEUX (GRAVELEUX)

PLAN DRAINAGE SOUTERRAIN

FERME ~~ANDRÉ CHABOT~~ PARK HURST

OT(S) P156 - P157 P153 - P280 - P278 - P277
ANG ST-CHARLES / RG EST DU CHEMIN CRAIG'S
MUNICIPALITE ST-PATRICE DE BEAURIVAGE
COMTE MUNICIPAL LOTBINIERE
DISTRICT ELECTORAL LOTBINIERE

PLAN NO: 5-2804-022 FEUILLE 1 DE 1

MINISTÈRE DE L'AGRICULTURE,

ES PÊCHERIES ET DE L'ALIMENTATION

ÉPOSÉ LE: 88-07-15

9308 P. C. & P. K. Hager (1)